North Carolina - Department of Environment and Natural Resources - Division of Water Quality - Groundwater Section
1636 Mail Service Center - Raleigh, N.C. 27699-1636 - Phone (919) 733-3221

242352

# WELL CONSTRUCTION RECORD

010833

**WELL CONTRACTOR:** Dewey Wright Well Pump Co., Inc.
**WELL CONTRACTOR CERTIFICATION #:** 2681
**STATE WELL CONSTRUCTION PERMIT#:** Steve Petty

1. **WELL USE (Check Applicable Box):** Residential [X] Municipal [ ] Industrial [ ] Agricultural [ ] Monitoring [ ] Recovery [ ] Heat Pump Water Injection [ ] Other [ ] If Other, List Use:

2. WELL LOCATION: (Show sketch of the location below)
Nearest Town: BANNER ELK County: AVERY
PRIVATE DR. OFF SR1319 OFF SAM ELLER RD. OFF H
(Road Name and Numbers, Community, or Subdivision and Lot No.)

3. DRILLING LOG

| DEPTH From | To | Formation Description |
|---|---|---|
| SO 0 | 15 | DIRT |
| 15 | 290 | GRANITE |
| 290 | 292 | QUARTZ |
| 292 | 305 | GRANITE |

If additional space is needed use back of form

4. DATE DRILLED 10/25/2001
5. TOTAL DEPTH 305
6. CUTTINGS COLLECTED YES [ ] NO [X]
7. DOES WELL REPLACE EXISTING WELL? YES [ ] NO [X]
8. STATIC WATER LEVEL Below Top of Casing: 70 FT.
(Use "+" if Above Top of Casing)
9. TOP OF CASING IS 1 FT. Above Land Surface*
***Top of casing terminated at/or below land surface requires a variance in accordance with 15A NCAC 2C.0118**
10. YIELD (gpm): 60 METHOD OF TEST Air
11. WATER ZONES (depth): 60 gpm 290-292 0 gpm
0 gpm 0 gpm
12. CHLORINATION: Type HTH Amount 47

RECEIVED/DENR
DWQ GROUNDWATER SECTION
01 NOV 19 PM 4:57

13. CASING:

| | Depth | | Diameter | Wall Thickness or Weight/Ft. | Material |
|---|---|---|---|---|---|
| From 0 | To 20 | Ft. | 6 1/8 | 350 | PVC |
| From | To | Ft. | | | |
| From | To | Ft. | | | |

14. GROUT:

| | Depth | | Material | Method |
|---|---|---|---|---|
| From 0 | To 20 | Ft. | Cement | Gravity Flow |
| From | To | Ft. | | |

15. SCREEN:

| | Depth | | Diameter | Slot Size | Material |
|---|---|---|---|---|---|
| From | To | Ft. | in. | in. | |
| From | To | Ft. | in. | in. | |
| From | To | Ft. | in. | in. | |

16. SAND/GRAVEL PACK:

| | Depth | | Size | Material |
|---|---|---|---|---|
| From | To | Ft. | | |
| From | To | Ft. | | |

RECEIVED
GROUNDWATER SECTION
ASHEVILLE REGIONAL OFFICE

LOCATION SKETCH
(Show direction and distance from at least two State Roads, or other map reference points)

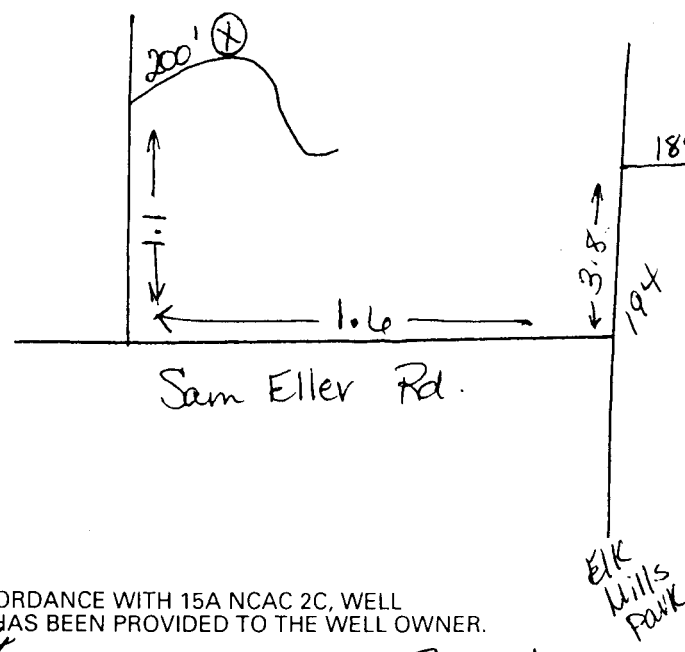


17. REMARKS:
I DO HEREBY CERTIFY THAT THIS WELL WAS CONSTRUCTED IN ACCORDANCE WITH 15A NCAC 2C, WELL CONSTRUCTION STANDARDS, AND THAT A COPY OF THIS RECORD HAS BEEN PROVIDED TO THE WELL OWNER.

Steve Petty 11-12-01
SIGNATURE OF PERSON CONSTRUCTING THE WELL DATE
Submit original to Division of Water Quality, Groundwater Section within 30 days

**FOR OFFICE USE ONLY**
Quad No:

GW-1 REV. 12/99