WSPO

305976

North Carolina - Department of Environment and Natural Resources - Division of Water Quality - Groundwater Section
1636 Mail Service Center - Raleigh, N.C. 27699-1636 - Phone (919) 733-3221

WELL CONSTRUCTION RECORD

040608

WELL CONTRACTOR: Dewey Wright Well Pump Co., Inc.
WELL CONTRACTOR CERTIFICATION #: 2686
STATE WELL CONSTRUCTION PERMIT#: Leslie Reece

1. **WELL USE (Check Applicable Box):** Residential [X] Municipal [ ] Industrial [ ] Agricultural [ ] Monitoring [ ] Recovery [ ] Heat Pump Water Injection [ ] Other [ ] If Other, List Use:

RECEIVED N.C. DEPT. OF EHNR JAN 31 2005 WATER QUALITY

2. WELL LOCATION: (Show sketch of the location below)
Nearest Town: BOONE County: WATAUGA
RAGAN RD. OFF HWY 194 OFF 421
(Road Name and Numbers, Community, or Subdivision and Lot No.)

3. DRILLING LOG

From	To	DEPTH Formation Description
0	60	DIRT
60	253	GRANITE
253	254	SHALE
254	305	GRANITE

If additional space is needed use back of form

4. DATE DRILLED 11/29/2004
5. TOTAL DEPTH 305
6. CUTTINGS COLLECTED YES [ ] NO [X]
7. DOES WELL REPLACE EXISTING WELL? YES [ ] NO [X]
8. STATIC WATER LEVEL Below Top of Casing: 50 FT.
(Use "+" if Above Top of Casing)
9. TOP OF CASING IS 1 FT. Above Land Surface*
*Top of casing terminated at/or below land surface requires a variance in accordance with 15A NCAC 2C.0118
10. YIELD (gpm): 5 METHOD OF TEST Air
11. WATER ZONES (depth): 5.00 gpm 253-254 0.00 gpm
0.00 gpm 0.00 gpm
12. CHLORINATION: Type HTH Amount 53

13. CASING:

	Depth From	Depth To	Diameter	Wall Thickness or Weight/Ft.	Material
	0	63	6 1/8	.350	PVC

14. GROUT:

	Depth From	Depth To	Material	Method
	0	20	Cement	Gravity Flow

15. SCREEN:

	Depth From	Depth To	Diameter	Slot Size	Material
			in.	in.	
			in.	in.	
			in.	in.	

16. SAND/GRAVEL PACK:

	Depth From	Depth To	Size	Material

LOCATION SKETCH
(Show direction and distance from at least two State Roads, or other map reference points)

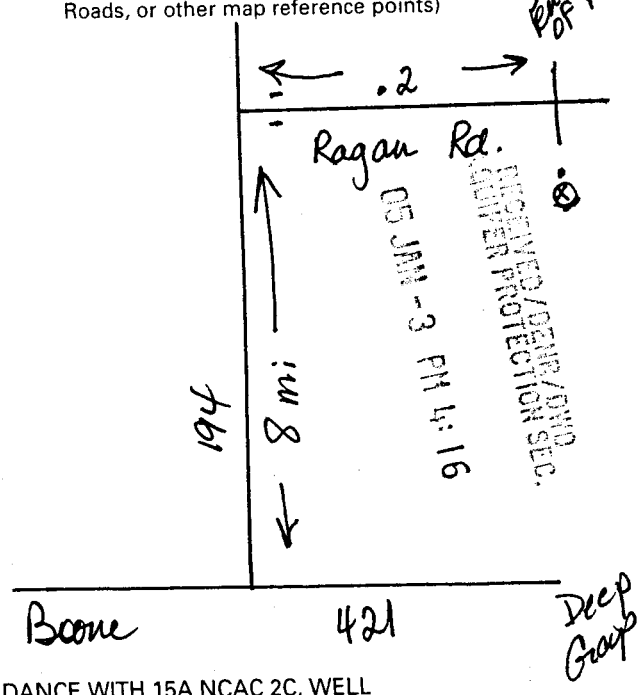

RECEIVED/DENR/DWQ WATER PROTECTION SEC. 05 JAN -3 PM 4:16

17. REMARKS:
I DO HEREBY CERTIFY THAT THIS WELL WAS CONSTRUCTED IN ACCORDANCE WITH 15A NCAC 2C, WELL CONSTRUCTION STANDARDS, AND THAT A COPY OF THIS RECORD HAS BEEN PROVIDED TO THE WELL OWNER.

Wayne Reece 12-10-04
SIGNATURE OF PERSON CONSTRUCTING THE WELL DATE
Submit original to Division of Water Quality, Groundwater Section within 30 days

FOR OFFICE USE ONLY
Quad No:
Serial No.

GW-1 REV. 12/99