WSRW

318070

North Carolina - Department of Environment and Natural Resources - Division of Water Quality - Groundwater Section
1636 Mail Service Center - Raleigh, N.C. 27699-1636 - Phone (919) 733-3221

WELL CONSTRUCTION RECORD

050305

WELL CONTRACTOR: Dewey Wright Well Pump Co., Inc.
WELL CONTRACTOR CERTIFICATION #: 2878
STATE WELL CONSTRUCTION PERMIT#: Steve Price

1. **WELL USE (Check Applicable Box):** Residential [X] Municipal [ ] Industrial [ ] Agricultural [ ] Monitoring [ ] Recovery [ ] Heat Pump Water Injection [ ] Other [ ] If Other, List Use: _____

2. WELL LOCATION: (Show sketch of the location below)
Nearest Town: BLOWING ROCK County: WATAUGA
HARMONY LN OFF FRIENDSHIP CHURCH RD. OFF AHO
(Road Name and Numbers, Community, or Subdivision and Lot No.)

3. DRILLING LOG / DEPTH

From	To	Formation Description
0	39	DIRT
39	388	GRANITE
388	390	QUARTZ
390	405	GRANITE

If additional space is needed use back of form

4. DATE DRILLED 9/15/2005
5. TOTAL DEPTH 405
6. CUTTINGS COLLECTED YES [ ] NO [X]
7. DOES WELL REPLACE EXISTING WELL? YES [ ] NO [X]
8. STATIC WATER LEVEL Below Top of Casing: 80 FT.
(Use "+" if Above Top of Casing)
9. TOP OF CASING IS 1 FT. Above Land Surface*
***Top of casing terminated at/or below land surface requires a variance in accordance with 15A NCAC 2C.0118**
10. YIELD (gpm): 2 METHOD OF TEST Air
11. WATER ZONES (depth): 2.00 gpm 388-390 0.00 gpm
0.00 gpm 0.00 gpm
12. CHLORINATION: Type HTH Amount 67

13. CASING:

Depth		Diameter	Wall Thickness or Weight/Ft.	Material
From 0	To 45 Ft.	6 1/8	350	PVC
From	To Ft.			
From	To Ft.			

14. GROUT:

Depth		Material	Method
From 0	To 20 Ft.	Cement	Gravity Flow
From	To Ft.		

15. SCREEN:

Depth		Diameter	Slot Size	Material
From	To Ft.	in.	in.	
From	To Ft.	in.	in.	
From	To Ft.	in.	in.	

16. SAND/GRAVEL PACK:

Depth		Size	Material
From	To Ft.		
From	To Ft.		

LOCATION SKETCH
(Show direction and distance from at least two State Roads, or other map reference points)

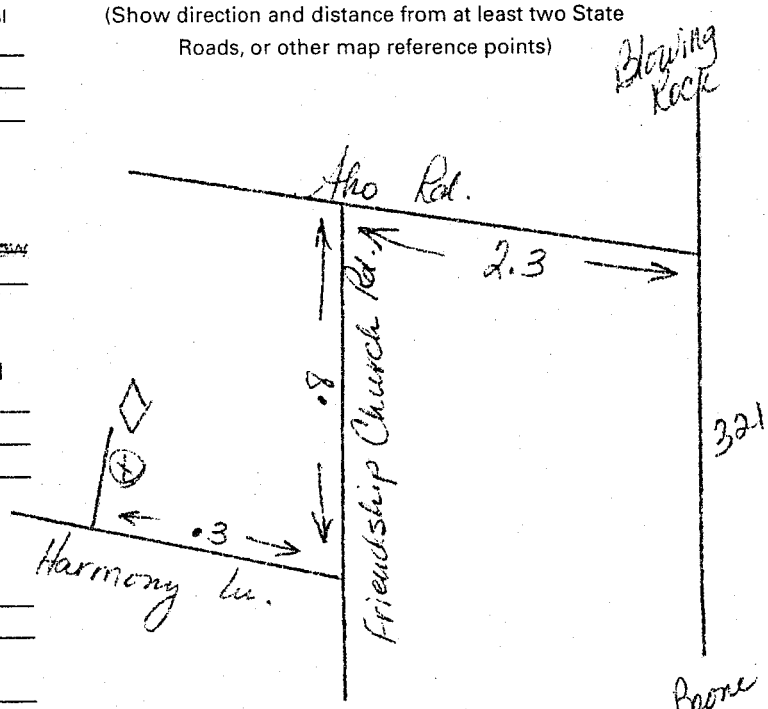

17. REMARKS: _____
I DO HEREBY CERTIFY THAT THIS WELL WAS CONSTRUCTED IN ACCORDANCE WITH 15A NCAC 2C, WELL CONSTRUCTION STANDARDS, AND THAT A COPY OF THIS RECORD HAS BEEN PROVIDED TO THE WELL OWNER.

Steven Price 10-12-05
SIGNATURE OF PERSON CONSTRUCTING THE WELL DATE
Submit original to Division of Water Quality, Groundwater Section within 30 days

FOR OFFICE USE ONLY
Quad No: _____
Serial No. _____

GW-1 REV. 12/99