North Carolina - Department of Environment and Natural Resources - Division of Water Quality - Groundwater Section
1636 Mail Service Center - Raleigh, N.C. 27699-1636 - Phone (919) 733-3221

302190

WELL CONSTRUCTION RECORD

040307

WELL CONTRACTOR: Dewey Wright Well Pump Co. Inc.
WELL CONTRACTOR CERTIFICATION #: 2681
STATE WELL CONSTRUCTION PERMIT#: Steve Petty

RECEIVED
N.C. Dept. of EHNR
OCT 15 2004
Winston-Salem Regional Office

1. WELL USE (Check Applicable Box): Residential [X] Municipal [ ] Industrial [ ] Agricultural [ ] Monitoring [ ] Recovery [ ] Heat Pump Water Injection [ ] Other [ ] If Other, List Use:

2. WELL LOCATION: (Show sketch of the location below)
Nearest Town: MOUNTAIN CITY County: WATAUGA
BEAR TRACK RD OFF SEASONS DR. OFF BEAVER DAM
(Road Name and Numbers, Community, or Subdivision and Lot No.)

DRILLING LOG

DEPTH From	To	Formation Description
0	85	DIRT
85	160	GRANITE
160	161	SHALE
161	385	GRANITE
385	387	SHALE
387	405	GRANITE

If additional space is needed use back of form

4. DATE DRILLED 8/9/2004
5. TOTAL DEPTH 405
6. CUTTINGS COLLECTED YES [ ] NO [X]
7. DOES WELL REPLACE EXISTING WELL? YES [ ] NO [X]
8. STATIC WATER LEVEL Below Top of Casing: 80 FT.
(Use "+" if Above Top of Casing)
9. TOP OF CASING IS 1 FT. Above Land Surface*
*Top of casing terminated at/or below land surface requires a variance in accordance with 15A NCAC 2C.0118
10. YIELD (gpm): 15 METHOD OF TEST Air
11. WATER ZONES (depth): 1.00 gpm 160-161 14.00 gpm 385-387
0.00 gpm 0.00 gpm
12. CHLORINATION: Type HTH Amount 67

RECEIVED/DENR/DWQ AQUIFER PROTECTION SEC. 04 SEP 24 PM 4:15

13. CASING:

	Depth From	To	Diameter	Wall Thickness or Weight/Ft.	Material
	0	90 Ft.	6 1/8	.350	PVC
		Ft.			
		Ft.			

14. GROUT:

	Depth From	To	Material	Method
	0	20 Ft.	Cement	Gravity Flow
		Ft.		

15. SCREEN:

	Depth From	To	Diameter	Slot Size	Material
		Ft.	in.	in.	
		Ft.	in.	in.	
		Ft.	in.	in.	

16. SAND/GRAVEL PACK:

	Depth From	To	Size	Material
		Ft.		
		Ft.		

LOCATION SKETCH
(Show direction and distance from at least two State Roads, or other map reference points)

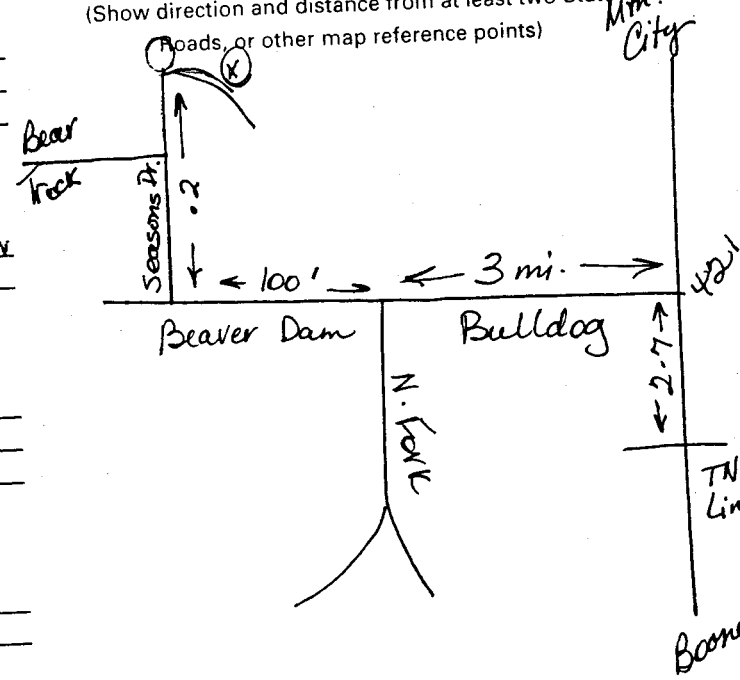

17. REMARKS:
I DO HEREBY CERTIFY THAT THIS WELL WAS CONSTRUCTED IN ACCORDANCE WITH 15A NCAC 2C, WELL CONSTRUCTION STANDARDS, AND THAT A COPY OF THIS RECORD HAS BEEN PROVIDED TO THE WELL OWNER.

Steve Petty 9-15-04
SIGNATURE OF PERSON CONSTRUCTING THE WELL DATE

Submit original to Division of Water Quality, Groundwater Section within 30 days

GW-1 REV. 12/99

FOR OFFICE USE ONLY
Quad No:
Serial No.