North Carolina - Department of Environment and Natural Resources - Division of Water Quality - Groundwater Section
1636 Mail Service Center - Raleigh, N.C. 27699-1636 - Phone (919) 733-3221

302207

WELL CONSTRUCTION RECORD

030199

WELL CONTRACTOR: Dewey Wright Well Pump Co., Inc.
WELL CONTRACTOR CERTIFICATION #: 2686
STATE WELL CONSTRUCTION PERMIT#: Leslie Reece

1. WELL USE (Check Applicable Box): Residential [X] Municipal [ ] Industrial [ ] Agricultural [ ] Monitoring [ ]
Recovery [ ] Heat Pump Water Injection [ ] Other [ ] If Other, List Use:

RECEIVED
N.C. Dept. of EHNR
OCT 15 2004
Winston-Salem
Regional Office

2. WELL LOCATION: (Show sketch of the location below)
Nearest Town: HOLD PILE County: WATAUGA
BENTLEY RD OFF WATAUGA RIVER RD OFF BROADST
(Road Name and Numbers, Community, or Subdivision and Lot No.)

DRILLING LOG From	To	DEPTH Formation Description
0	18	DIRT
18	825	GRANITE

4. DATE DRILLED 4/21/2004
5. TOTAL DEPTH 825
6. CUTTINGS COLLECTED YES [ ] NO [X]
7. DOES WELL REPLACE EXISTING WELL? YES [ ] NO [X]
8. STATIC WATER LEVEL Below Top of Casing: 825 FT.
(Use "+" if Above Top of Casing)
9. TOP OF CASING IS 1 FT. Above Land Surface*
*Top of casing terminated at/or below land surface requires a variance in accordance with 15A NCAC 2C.0118
10. YIELD (gpm): 1 METHOD OF TEST Air
11. WATER ZONES (depth): 1.00 gpm UNKNOWN 0.00 gpm
0.00 gpm 0.00 gpm
If additional space is needed use back of form

RECEIVED/DENR/DWQ AQUIFER PROTECTION SEC.
04 SEP 24 PM 4:16

12. CHLORINATION: Type HTH Amount

13. CASING:

	Depth From	To	Diameter	Wall Thickness or Weight/Ft.	Material
	0	21 Ft.	6 1/8	350	PVC
		Ft.			
		Ft.			

14. GROUT:

	Depth From	To	Material	Method
	0	20 Ft.	Cement	Gravity Flow
		Ft.		

15. SCREEN:

	Depth From	To	Diameter	Slot Size	Material
		Ft.	in.	in.	
		Ft.	in.	in.	
		Ft.	in.	in.	

16. SAND/GRAVEL PACK:

	Depth From	To	Size	Material
		Ft.		
		Ft.		

LOCATION SKETCH
(Show direction and distance from at least two State Roads, or other map reference points)

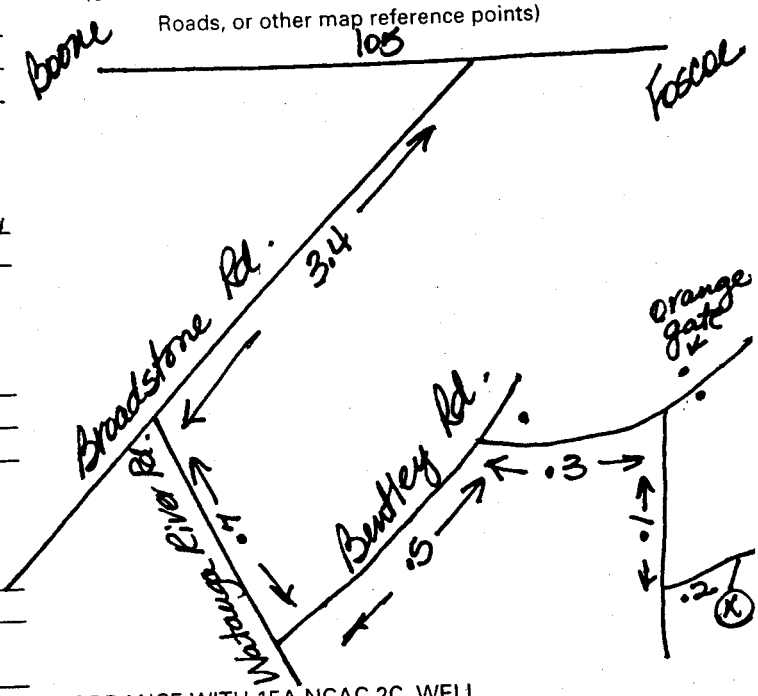

17. REMARKS:
I DO HEREBY CERTIFY THAT THIS WELL WAS CONSTRUCTED IN ACCORDANCE WITH 15A NCAC 2C, WELL CONSTRUCTION STANDARDS, AND THAT A COPY OF THIS RECORD HAS BEEN PROVIDED TO THE WELL OWNER.

Wayne Reece 9-16-04
SIGNATURE OF PERSON CONSTRUCTING THE WELL DATE
Submit original to Division of Water Quality, Groundwater Section within 30 days
GW-1 REV. 12/99

FOR OFFICE USE ONLY
Quad No:
Serial No.