304703

North Carolina - Department of Environment and Natural Resources - Division of Water Quality - Groundwater Section
1636 Mail Service Center - Raleigh, N.C. 27699-1636 - Phone (919) 733-3221

WELL CONSTRUCTION RECORD

040545

WELL CONTRACTOR: Dewey Wright Well Pump Co., Inc.
WELL CONTRACTOR CERTIFICATION #: 2686
STATE WELL CONSTRUCTION PERMIT#: Leslie Reece

1. **WELL USE (Check Applicable Box):** Residential [X] Municipal [ ] Industrial [ ] Agricultural [ ] Monitoring [ ]
Recovery [ ] Heat Pump Water Injection [ ] Other [ ] If Other, List Use:

2. WELL LOCATION: (Show sketch of the location below)
Nearest Town: BLOWING ROCK County: WATAUGA
AHO RD. OFF AHO RD.
(Road Name and Numbers, Community, or Subdivision and Lot No.)

DRILLING LOG From	To	DEPTH Formation Description
0	90	DIRT
90	130	GRANITE
130	135	QUARTZ
135	200	GRANITE

If additional space is needed use back of form

4. DATE DRILLED 10/21/2004
5. TOTAL DEPTH 200
6. CUTTINGS COLLECTED YES [ ] NO [X]
7. DOES WELL REPLACE EXISTING WELL? YES [ ] NO [X]
8. STATIC WATER LEVEL Below Top of Casing: 40 FT.
(Use "+" if Above Top of Casing)
9. TOP OF CASING IS 1 FT. Above Land Surface*
*Top of casing terminated at/or below land surface requires a variance in accordance with 15A NCAC 2C 0118
10. YIELD (gpm): 100 METHOD OF TEST Air
11. WATER ZONES (depth): 100.00 gpm 130-135 0.00 gpm
0.00 gpm 0.00 gpm
12. CHLORINATION: Type HTH Amount 32

13. CASING:

	Depth From	To	Diameter	Wall Thickness or Weight/Ft.	Material
From	0	To 98 Ft.	6 1/8	.350	PVC
From		To Ft.			
From		To Ft.			

14. GROUT:

	Depth From	To	Material	Method
From	0	To 20 Ft.	Cement	Gravity Flow
From		To Ft.		

15. SCREEN:

	Depth From	To	Diameter	Slot Size	Material
From		To Ft.	in.	in.	
From		To Ft.	in.	in.	
From		To Ft.	in.	in.	

16. SAND/GRAVEL PACK:

	Depth From	To	Size	Material
From		To Ft.		
From		To Ft.		

LOCATION SKETCH
(Show direction and distance from at least two State Roads, or other map reference points)

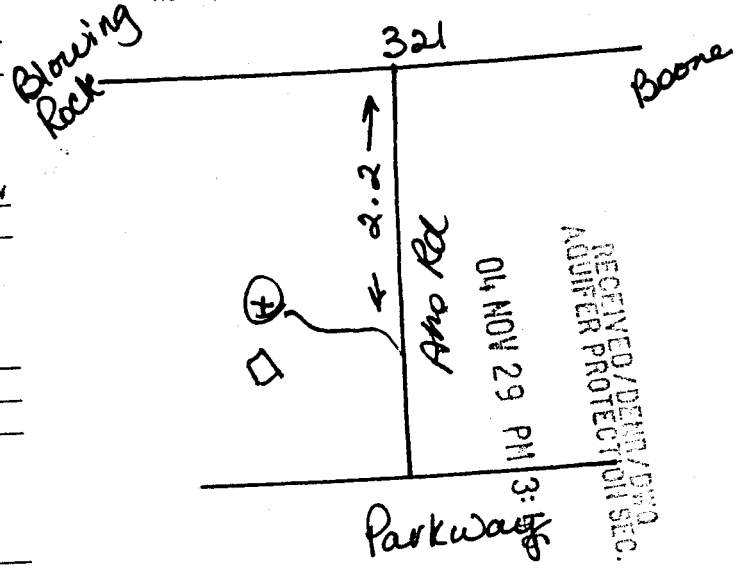

RECEIVED/DENR/DWQ AQUIFER PROTECTION SEC. 04 NOV 29 PM 3:

17. REMARKS:
I DO HEREBY CERTIFY THAT THIS WELL WAS CONSTRUCTED IN ACCORDANCE WITH 15A NCAC 2C, WELL CONSTRUCTION STANDARDS, AND THAT A COPY OF THIS RECORD HAS BEEN PROVIDED TO THE WELL OWNER.

Wayne Reece 11-23-04
SIGNATURE OF PERSON CONSTRUCTING THE WELL DATE

Submit original to Division of Water Quality, Groundwater Section within 30 days

GW-1 REV. 12/99

FOR OFFICE USE ONLY
Quad No: