North Carolina - Department of Environment and Natural Resources - Division of Water Quality - Groundwater Section
1636 Mail Service Center - Raleigh, N.C. 27699-1636 - Phone (919) 733-3221

304706

# WELL CONSTRUCTION RECORD

040243

WELL CONTRACTOR: Dewey Wright Well Pump Co., Inc.
WELL CONTRACTOR CERTIFICATION #: 2686
STATE WELL CONSTRUCTION PERMIT#: Leslie Reece

1. WELL USE (Check Applicable Box): Residential [X] Municipal [ ] Industrial [ ] Agricultural [ ] Monitoring [ ] Recovery [ ] Heat Pump Water Injection [ ] Other [ ] If Other, List Use:

2. WELL LOCATION: (Show sketch of the location below)
Nearest Town: ~~IN HOLD PILE~~ Boone County: WATAUGA
GRADY WINKLER RD. OFF HOWARDS CREEK RD OFF
(Road Name and Numbers, Community, or Subdivision and Lot No.)

| DRILLING LOG From | To | DEPTH Formation Description |
|---|---|---|
| 0 | 129 | MUD GRAVEL |
| 129 | 900 | GRANITE |

4. DATE DRILLED 9/16/2004
5. TOTAL DEPTH 900
6. CUTTINGS COLLECTED YES [ ] NO [X]
7. DOES WELL REPLACE EXISTING WELL? YES [ ] NO [X]
8. STATIC WATER LEVEL Below Top of Casing: _____ FT. (Use "+" if Above Top of Casing)
9. TOP OF CASING IS 1 FT. Above Land Surface*
*Top of casing terminated at/or below land surface requires a variance in accordance with 15A NCAC 2C.0118
10. YIELD (gpm): 0 METHOD OF TEST Air
11. WATER ZONES (depth): 0.00 gpm DRY HOLE 0.00 gpm
0.00 gpm 0.00 gpm
12. CHLORINATION: Type HTH Amount

If additional space is needed use back of form

RECEIVED/DENR/DWQ
AQUIFER PROTECTION SEC.
04 NOV 29 PM 3:46

13. CASING:

| Depth From | To | Diameter | Wall Thickness or Weight/Ft. | Material |
|---|---|---|---|---|
| 0 | 134 Ft. | 6 1/4 | .188 | GALV |
| | Ft. | | | |
| | Ft. | | | |

14. GROUT:

| Depth From | To | Material | Method |
|---|---|---|---|
| 0 | 20 Ft. | Cement | Gravity Flow |
| | Ft. | | |

15. SCREEN:

| Depth From | To | Diameter | Slot Size | Material |
|---|---|---|---|---|
| | Ft. | in. | in. | |
| | Ft. | in. | in. | |
| | Ft. | in. | in. | |

16. SAND/GRAVEL PACK:

| Depth From | To | Size | Material |
|---|---|---|---|
| | Ft. | | |
| | Ft. | | |

LOCATION SKETCH
(Show direction and distance from at least two State Roads, or other map reference points)

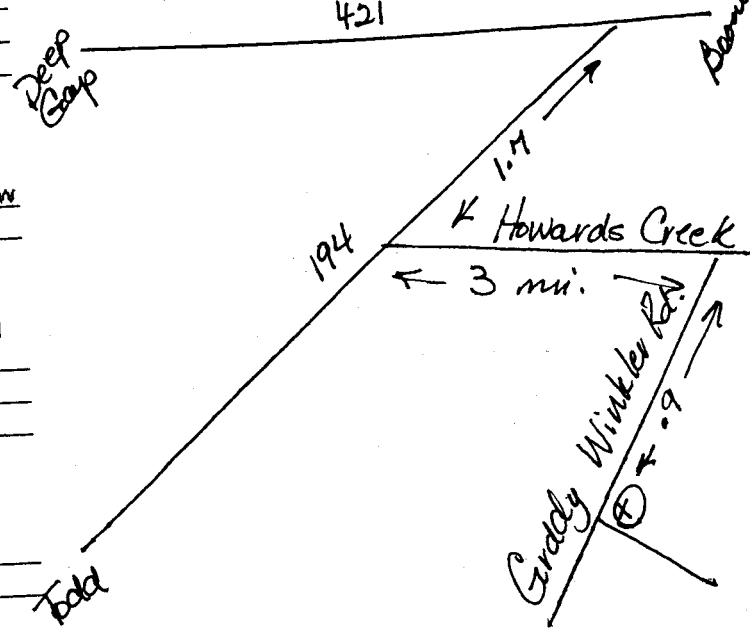


17. REMARKS:
I DO HEREBY CERTIFY THAT THIS WELL WAS CONSTRUCTED IN ACCORDANCE WITH 15A NCAC 2C, WELL CONSTRUCTION STANDARDS, AND THAT A COPY OF THIS RECORD HAS BEEN PROVIDED TO THE WELL OWNER.

Wayne Reece 11-23-04
SIGNATURE OF PERSON CONSTRUCTING THE WELL DATE
Submit original to Division of Water Quality, Groundwater Section within 30 days

FOR OFFICE USE ONLY
Quad No:

GW-1 REV. 12/99