304726

North Carolina - Department of Environment and Natural Resources - Division of Water Quality - Groundwater Section
1636 Mail Service Center - Raleigh, N.C. 27699-1636 - Phone (919) 733-3221

WELL CONSTRUCTION RECORD

040502

WELL CONTRACTOR: Dewey Wright Well Pump Co., Inc.
WELL CONTRACTOR CERTIFICATION #: 2878
STATE WELL CONSTRUCTION PERMIT#: Steve Price

1. **WELL USE (Check Applicable Box):** Residential [X] Municipal [ ] Industrial [ ] Agricultural [ ] Monitoring [ ] Recovery [ ] Heat Pump Water Injection [ ] Other [ ] If Other, List Use:

2. WELL LOCATION: (Show sketch of the location below)
Nearest Town: BOONE County: WATAUGA
OLD BRISTOL RD. OFF HWY 421
(Road Name and Numbers, Community, or Subdivision and Lot No.)

4. DATE DRILLED 10/12/2004
5. TOTAL DEPTH 245
6. CUTTINGS COLLECTED YES [ ] NO [X]
7. DOES WELL REPLACE EXISTING WELL? YES [ ] NO [X]
8. STATIC WATER LEVEL Below Top of Casing: 80 FT.
(Use "+" if Above Top of Casing)
9. TOP OF CASING IS 1 FT. Above Land Surface*
*Top of casing terminated at/or below land surface requires a variance in accordance with 15A NCAC 2C.0118
10. YIELD (gpm): 15 METHOD OF TEST Air
11. WATER ZONES (depth): 1.00 gpm 195-196 14.00 gpm 235-236
0.00 gpm 0.00 gpm
12. CHLORINATION: Type HTH Amount 35

DRILLING LOG From	To	DEPTH Formation Description
0	85	MUD ROCKS
85	195	GRANITE
195	196	QUARTZ
196	235	GRANITE
235	236	QUARTZ
236	245	GRANITE

If additional space is needed use back of form

13. CASING:

	Depth From	To	Ft.	Diameter	Wall Thickness or Weight/Ft.	Material
	0	91		6 1/4	.188	GALV

14. GROUT:

	Depth From	To	Ft.	Material	Method
	0	20		Cement	Gravity Flow

15. SCREEN:

	Depth From	To	Ft.	Diameter	Slot Size	Material
				in.	in.	
				in.	in.	
				in.	in.	

16. SAND/GRAVEL PACK:

	Depth From	To	Ft.	Size	Material

LOCATION SKETCH
(Show direction and distance from at least two State Roads, or other map reference points)

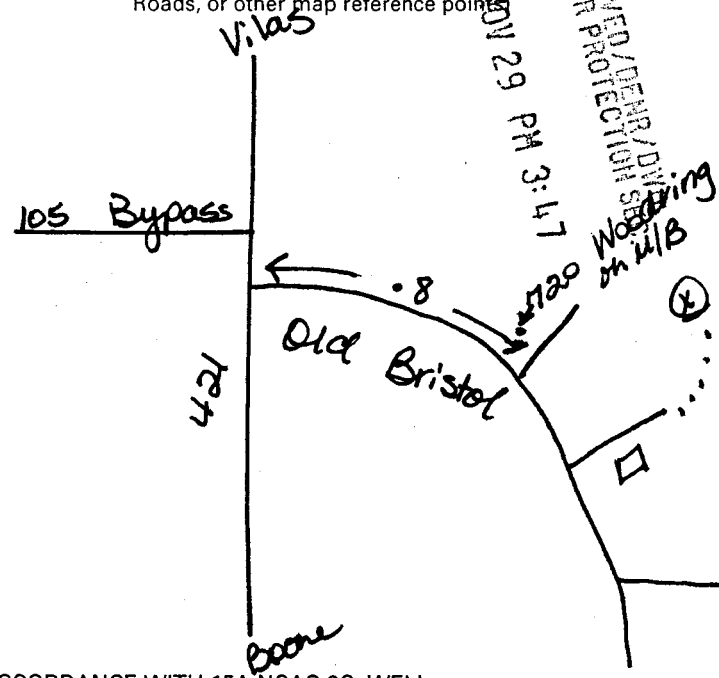

RECEIVED/DENR/DIVISION OF WATER QUALITY PROTECTION SECTION
NOV 29 PM 3:47

17. REMARKS:
I DO HEREBY CERTIFY THAT THIS WELL WAS CONSTRUCTED IN ACCORDANCE WITH 15A NCAC 2C, WELL CONSTRUCTION STANDARDS, AND THAT A COPY OF THIS RECORD HAS BEEN PROVIDED TO THE WELL OWNER.

Steven Price 11-18-04
SIGNATURE OF PERSON CONSTRUCTING THE WELL DATE
Submit original to Division of Water Quality, Groundwater Section within 30 days

FOR OFFICE USE ONLY
Quad No:
Serial No:

GW-1 REV. 12/99