99 697

North Carolina - Department of Environment, Health, and Natural Resources
Division of Environmental Management - Groundwater Section
P.O. Box 29535 - Raleigh, N.C. 27626-0535
Phone (919) 733-3221

FOR OFFICE USE ONLY
QUAD. NO. _____ SERIAL NO. 206531
Lat. _____ Long. _____ Pc _____
Minor Basin _____
Basin Code _____
Header Ent. _____ GW-1 Ent

WELL CONSTRUCTION RECORD

DRILLING CONTRACTOR: Dewey Wright Well & Pump Co. Inc.
DRILLER REGISTRATION NUMBER: 266
STATE WELL CONSTRUCTION PERMIT NUMBER: Steve Reece

1. WELL LOCATION: (Show sketch of the location below)
Nearest Town: Banner Elk County: AVERY
LOT #6-1/10 UP ROCKY KNOB OFF SHAWNEE
(Road, Community, or Subdivision and Lot No.)

DEPTH From	DEPTH To	DRILLING LOG Formation Description
0	20	DIRT
20	400	GRANITE
400	404	QUARTZ
404	585	GRANITE

If additional space is needed use back of form

3. DATE DRILLED 11/22/99 USE OF WELL PVT
4. TOTAL DEPTH 585'
5. CUTTINGS COLLECTED YES [ ] NO [x]
6. DOES WELL REPLACE EXISTING WELL? YES [ ] NO [x]
7. STATIC WATER LEVEL Below Top of Casing: 40 FT.
(Use "+" if Above Top of Casing)
8. TOP OF CASING IS 1 FT. Above Land Surface*
* Casing Terminated at/or below land surface is illegal unless a variance is issued in accordance with 15A NCAC 2C .0118
9. YIELD (gpm): 2 METHOD OF TEST AIR
10. WATER ZONES (depth): 2 gpm 400-404'
11. CHLORINATION: Type HTH Amount 112 tabs
12. CASING:

	Depth From	Depth To	Ft.	Diameter	Wall Thickness or Weight/Ft.	Material
	0	26		6 1/4	0.188	GALV

13. GROUT:

	Depth From	Depth To	Ft.	Material	Method
	0	20		CEMENT	PUMPED

14. SCREEN:

	Depth From	Depth To	Ft.	Diameter	Slot Size	Material
				in.	in.	
				in.	in.	
				in.	in.	

15. SAND/GRAVEL PACK:

	Depth From	Depth To	Ft.	Size	Material

LOCATION SKETCH
(Show direction and distance from at least two State Roads, or other map reference points)

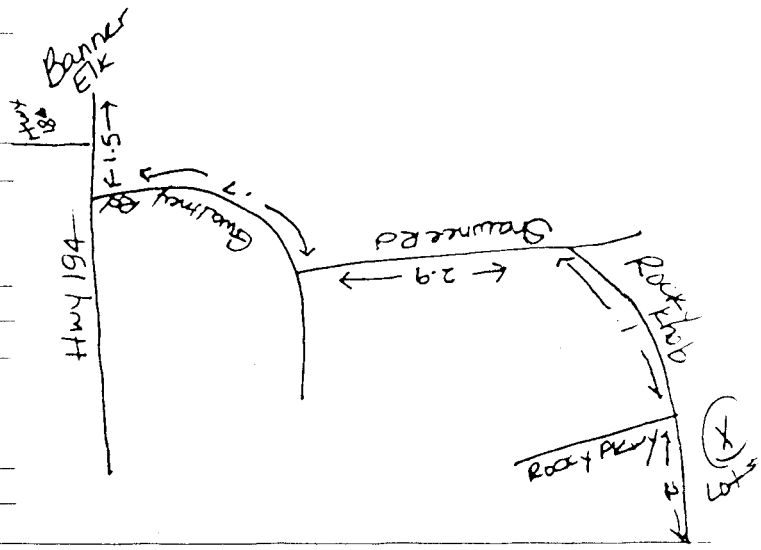

16. REMARKS:

I DO HEREBY CERTIFY THAT THIS WELL WAS CONSTRUCTED IN ACCORDANCE WITH 15A NCAC 2C, WELL CONSTRUCTION STANDARDS, AND THAT A COPY OF THIS RECORD HAS BEEN PROVIDED TO THE WELL OWNER.

RECEIVED JAN 31 2000

Angie Greene 1-26-00
SIGNATURE OF CONTRACTOR OR AGENT DATE

GW-1 REV. 5/91
Submit original to Division of Environmental Management and copy to well owner

00 FEB -8 AM 11:00